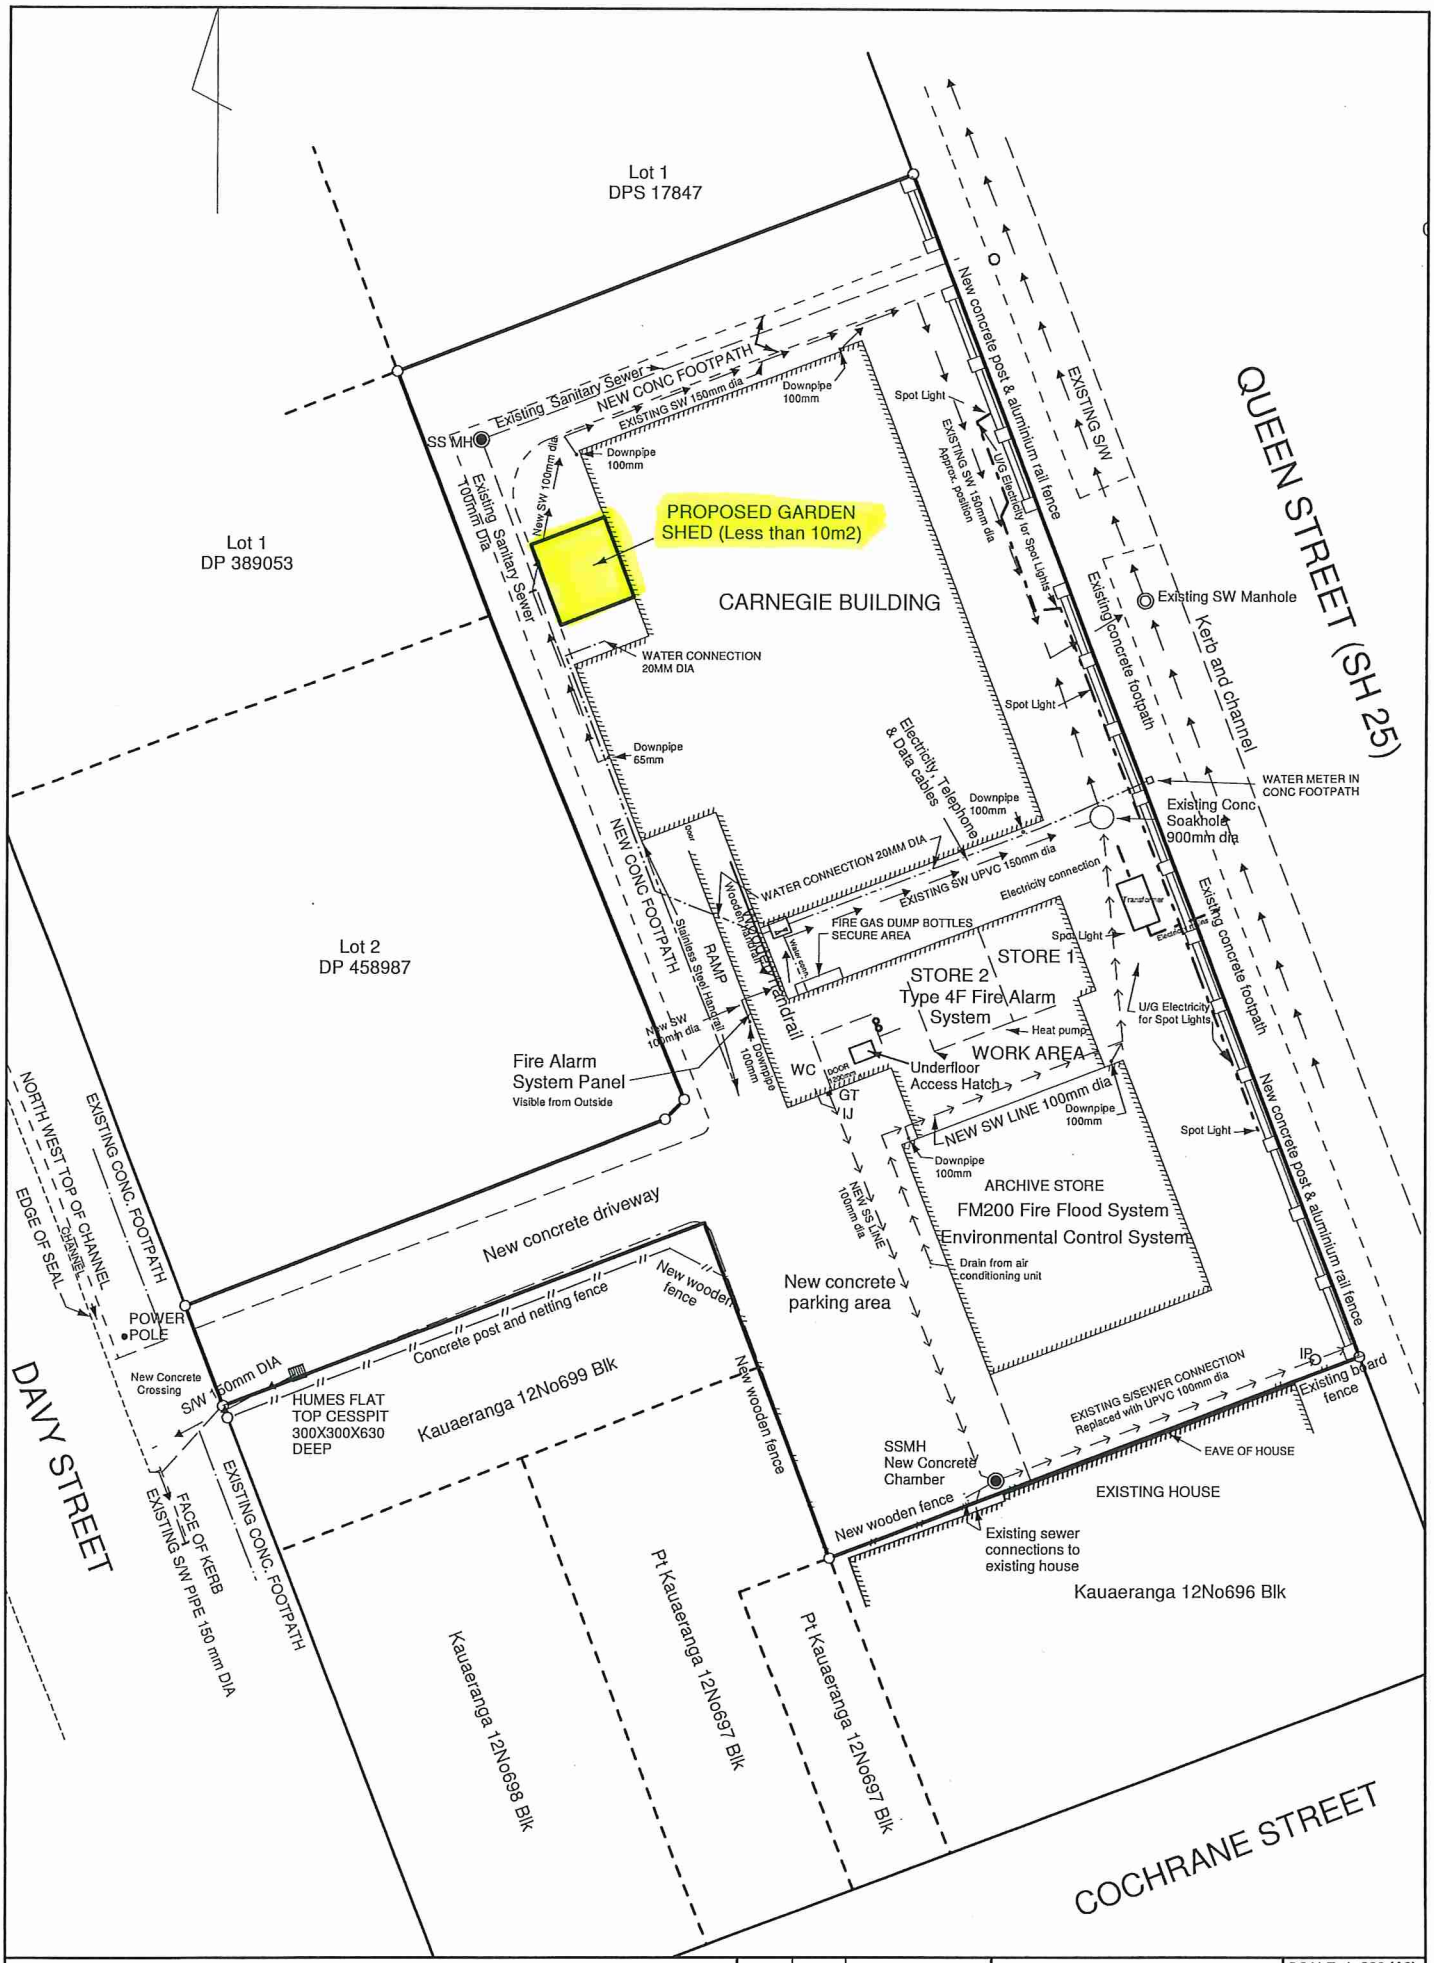

AS BUILT PLAN - SERVICES & SYSTEMS

THE COROMANDEL HERITAGE TRUST - CARNEGIE BUILDING & ARCHIVE

THE TREASURY 705 QUEEN STREET (SH25) THAMES - BUILDING CONSENT ABA2011/568

DATE	INITIAL	AMENDMENT
20.6.14	MJD	DRAFT

DUNWOODIE & GREEN SURVEYORS LTD

LAND DEVELOPMENT SPECIALISTS

541 POLLEN ST THAMES

Ph (07) 868 7587 FAX (07) 868 8252

SCALE 1 :200 (A3)

DATE JUNE 2014

SHEET 1

FILE: 4826

CCAD FILE 4826Eng\ASBUILT1:200